


1201 MARYLAND AVENUE, SW

1ST LEVEL - 2,013 SPEC SUITE (AS-BUILT PLAN)



D STREET

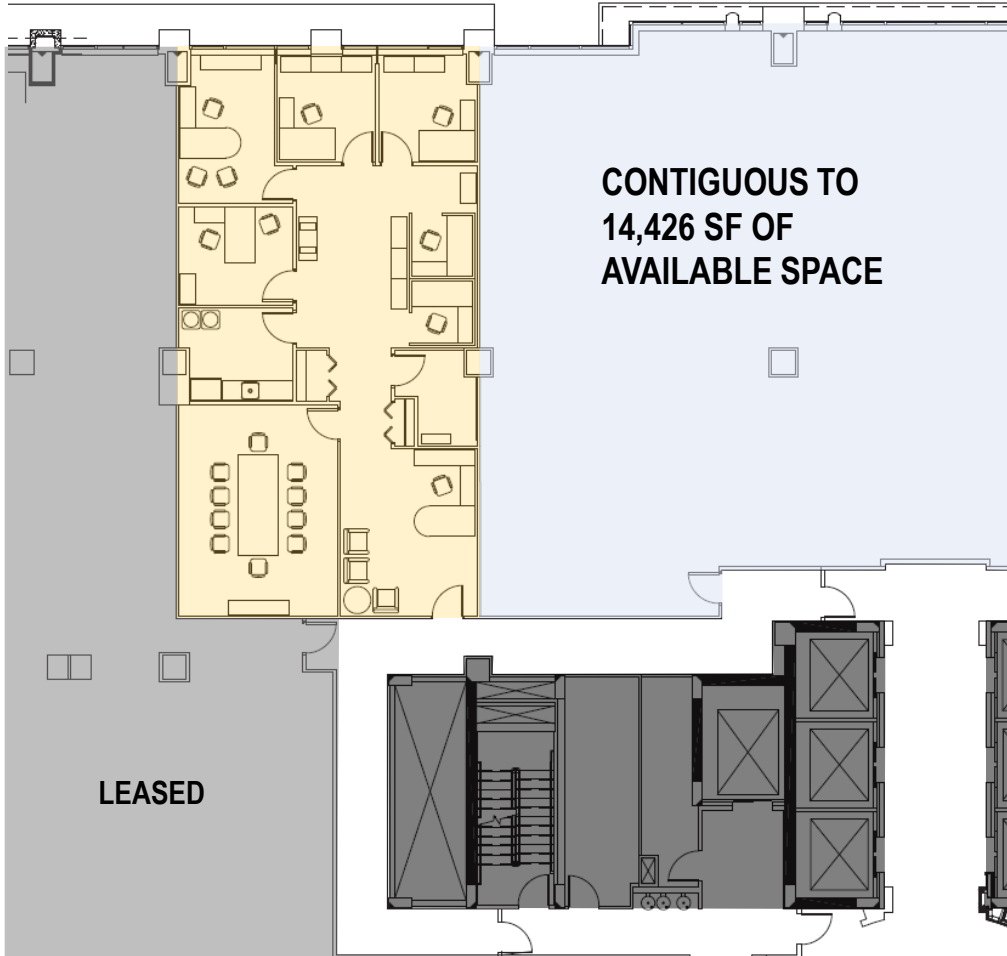

**HIGH-END SPEC SUITE
AVAILABLE IMMEDIATELY**

**VIEWS OVERLOOKING
D STREET**

**BUILT OUT WITH 4 OFFICES AND
SPACE FOR 3 WORKSTATIONS**

**LARGE CONFERENCE ROOM &
MODERN PANTRY AREA**

